FITTINGS
① Ø100 x 11.25° BEND
② Ø100 x 22.5° BEND
③ Ø100 x 45° BEND
④ Ø100 x 90° BEND

LEGEND

- *New 100Ø Water Main*
- HC *New Service Connection*
- FH *New Hydrant*
- SV *New Section Valve*

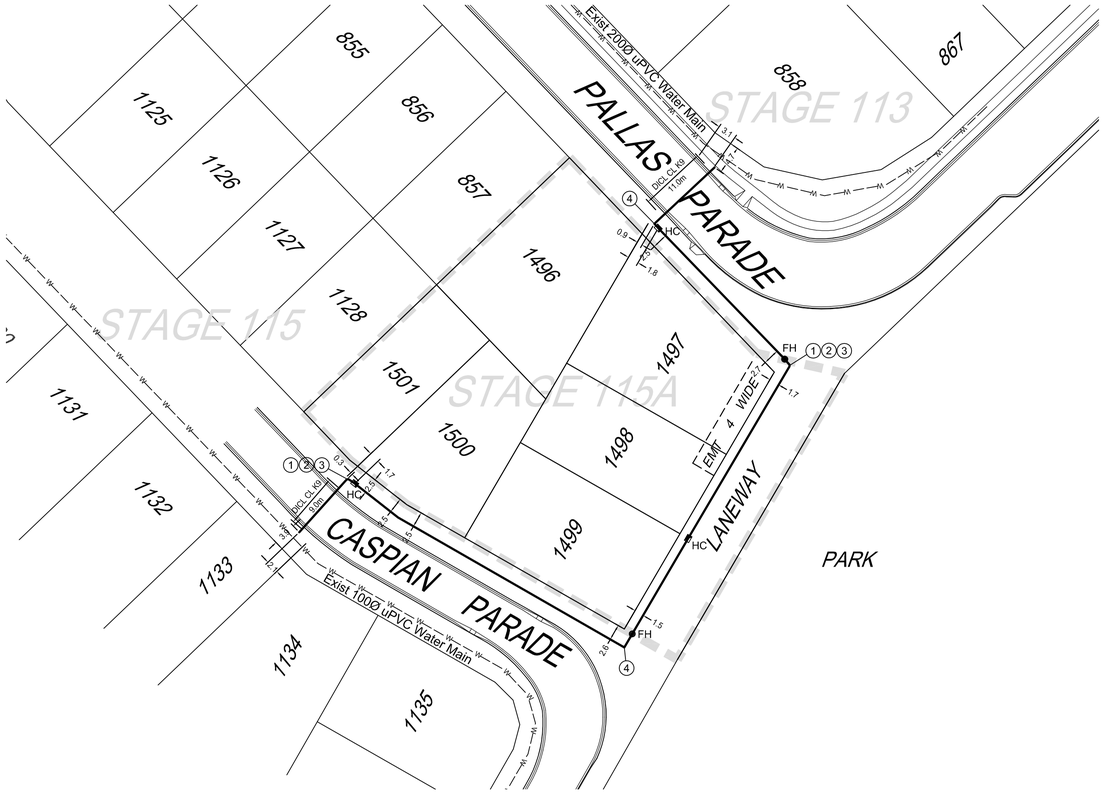

I, ... Peter Sippel ..... being a cadastral surveyor and duly authorised representative of Heilbronn & Partners Pty Ltd hereby:

- certify the information contained in this drawing is an accurate as constructed representation of the works
- accept responsibility for the as constructed information contained in this drawing
- acknowledge the as constructed information contained in the drawing may be relied on by council and others

Certification of Stage 115A by ..... on 7/7/2011
(Signature) (Date)

for Heilbronn & Partners Pty Ltd

NOTES:

1) All pipes are uPVC Class 16 u.n.o.

2) Trench construction and cover over mains is in accordance with STD DRG No. 8-40010.

3) Concrete thrust blocks and anchor blocks are placed at all bends and fittings. Thrust block sizing is in accordance with STD DRG No. 8-0006.

4) Road crossings are DICL class K9 with minimum cover of full depth of road pavement plus 150mm.

0 25m 50mm 50m 100mm 75m 150mm SCALE BAR

Warner Lakes
For
PEET

IMPORTANT NOTES: (These notes are an integral part of this plan)
This Plan has been prepared to **MBRC** standards, for the Purpose of recording the As Constructed details of a new service reticulation for Council Approval and should not be used for any other purpose.

No report is made on any other services, nor any services that may exist before or be constructed after, the time of survey, or constructed under any other approval.

The property boundaries, easements and lot numbers shown hereon may be proposed only and subject to registration by the Department of Environment and Resource Management. All property information should be determined from the registered Survey Plans.

All dimensions should be verified and confirmed against the latest information prior to commencement by any person using this plan for building purposes.

Heilbronn & Partners Pty Ltd accepts no responsibility for any changes made to construction or otherwise, after the date of this plan. Any discrepancies should be clarified in writing with the relevant Authority prior to commencement of the work.

THESE DESIGNS AND DRAWINGS ARE COPYRIGHT AND ARE NOT TO BE USED OR REPRODUCED WITHOUT THE WRITTEN PERMISSION OF THG

Data Sources	
Cadastral Boundaries	C4883-CC01-Adwg
Contours	THG
Engineering Design	Brown Consulting

No	Revisions	Date	Chkd
B	Amend certification panel, remove valve,	7/7/11	EJM
A	Original	25/6/11	EJM

Parish:	WARNER
County:	Stanley
Locality:	WARNER
Local Authority:	M.B.R.C
Map Reference :	9443-21132
Horizontal Meridian:	SP225266
Vertical Level Datum:	AHD D
Level Origin:	PM183408 (RL40.827)
Scale:	1:500 @A1
Surveyed:	DC
Designed:	Brown Consulting
Drawn:	EJM
Checked:	EJM
Plot Date:	07 Jul 2011
Computer File Ref:	C5278-AW1-B.dwg

AS CONSTRUCTED WATER RETICULATION Stage 115A

BRISBANE (07) 3666 4700 GOLD COAST (07) 5574 0588 SAMFORD (07) 3289 1466
Email mail@thg.com.au www.thg.com.au
ABN 58 918 746 490 Heilbronn & Partners Pty Ltd trading as THG

Drawing No C5278-AW1 Issue B